


SCALE BAR, EACH BLOCK IS 12" LONG

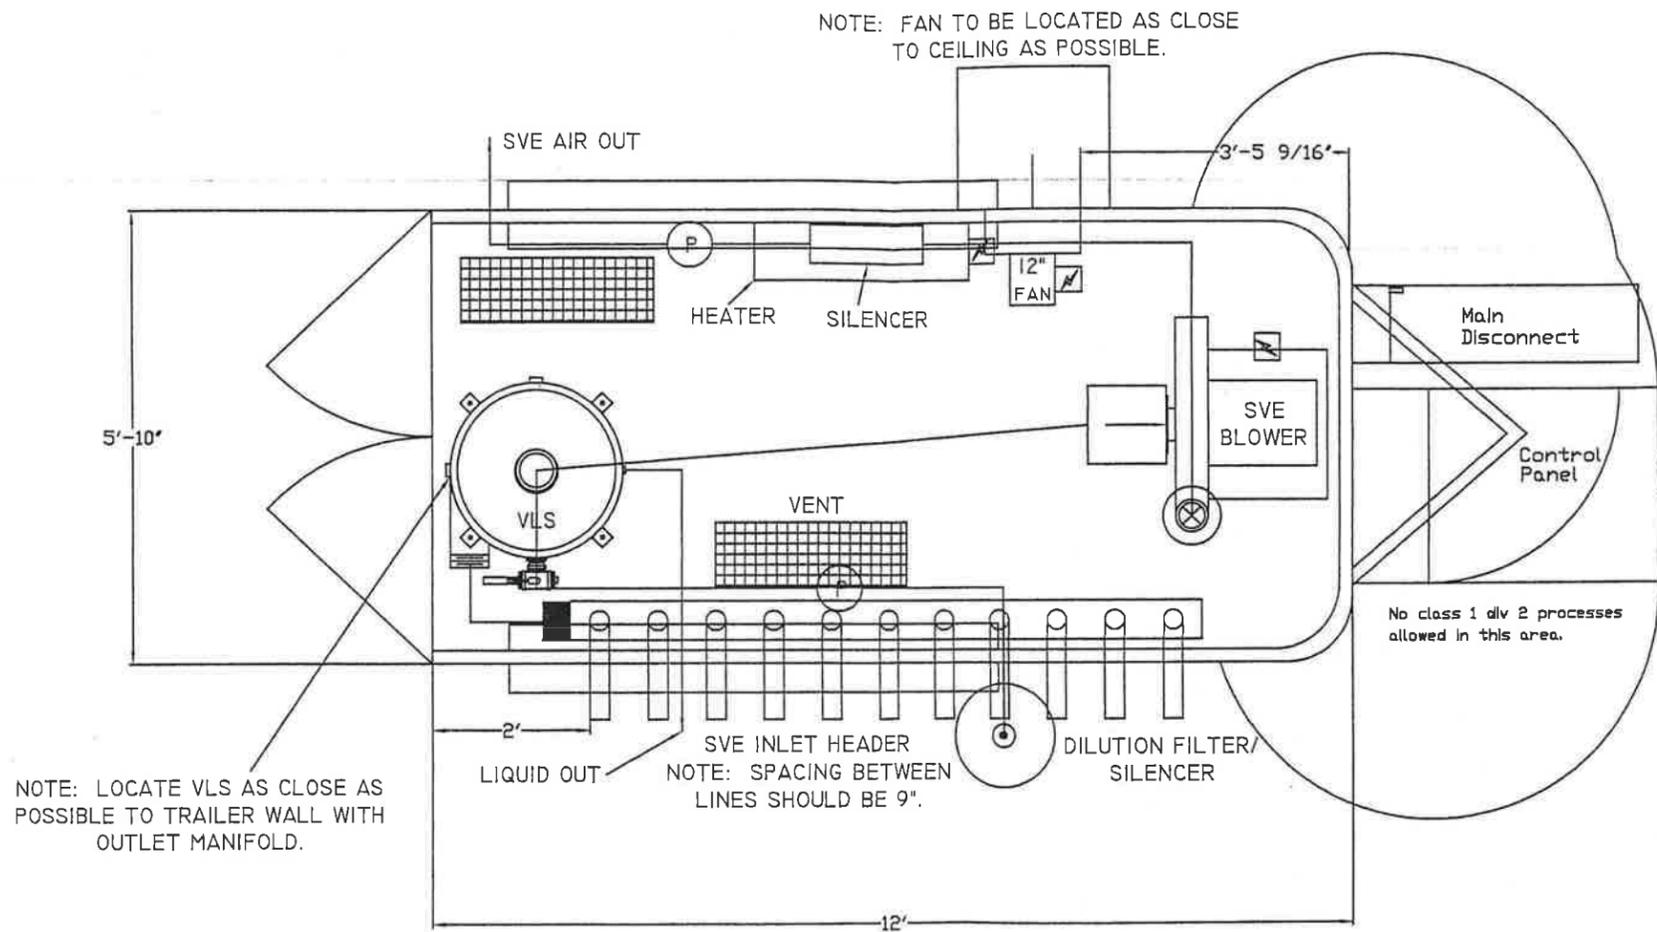

No class 1 div 2 processes allowed in this area.

*** SPECIAL PROJECT NOTES ***

- FAN AND LOUVER HOODS NEED TO BE INSTALLED ON SITE. CANNOT SHIP WITH HOODS ATTACHED.
- LOCATE COOLING THERMOSTAT IN THE WARMEST LOCATION AT CEILING LEVEL.
- LOCATE HEATING THERMOSTAT AT FLOOR LEVEL.
- BUILDING TO HAVE INSULATED WALLS AND CEILING.
- NOISE LIMIT: 80 DB MAX AT 3 FT
- VIBRATION ISOLATORS UNDER EQUIPMENT.

*** PACKING LIST ***

DESCRIPTION	DIM (L X W X H)	WEIGHT
TRAILER	6'X12'X8.5'	3500 LBS

FLOW DIRECTION	FLOW INTO THE PAGE	THIS AREA REPRESENTS SERVICE SPACE REQUIRED
ELECTRICAL CONNECTION	FLOW OUT OF THE PAGE	

THIS INFORMATION IS THE PROPERTY OF MLEE INC. AND CANNOT BE REUSED OR REPRODUCED WITHOUT THE WRITTEN CONSENT OF MLEE EQUIPMENT INC.

LEVEL	DATE	BY	REVISION
C	JAN 23, 07	JH	AS BUILT
B	DEC 18, 06	JH	FOR PRODUCTION
A	NOV 30, 06	JH	FOR APPROVAL

DWG. NO.	50222- 02
TITLE	SYSTEM LAYOUT
CUSTOMER	GSI - GRAND ISLAND GEOTECHNICAL SERVICES INC.
	MLEE EQUIPMENT INC.