PACKING LIST		
DESCRIPTION	DIM (LXWXH)	WEIGHT
SHIPPING CONTAINER	21.5'X8.5'X9'	15000LB
BOX OF PARTS	3'X3'X3'	60LB

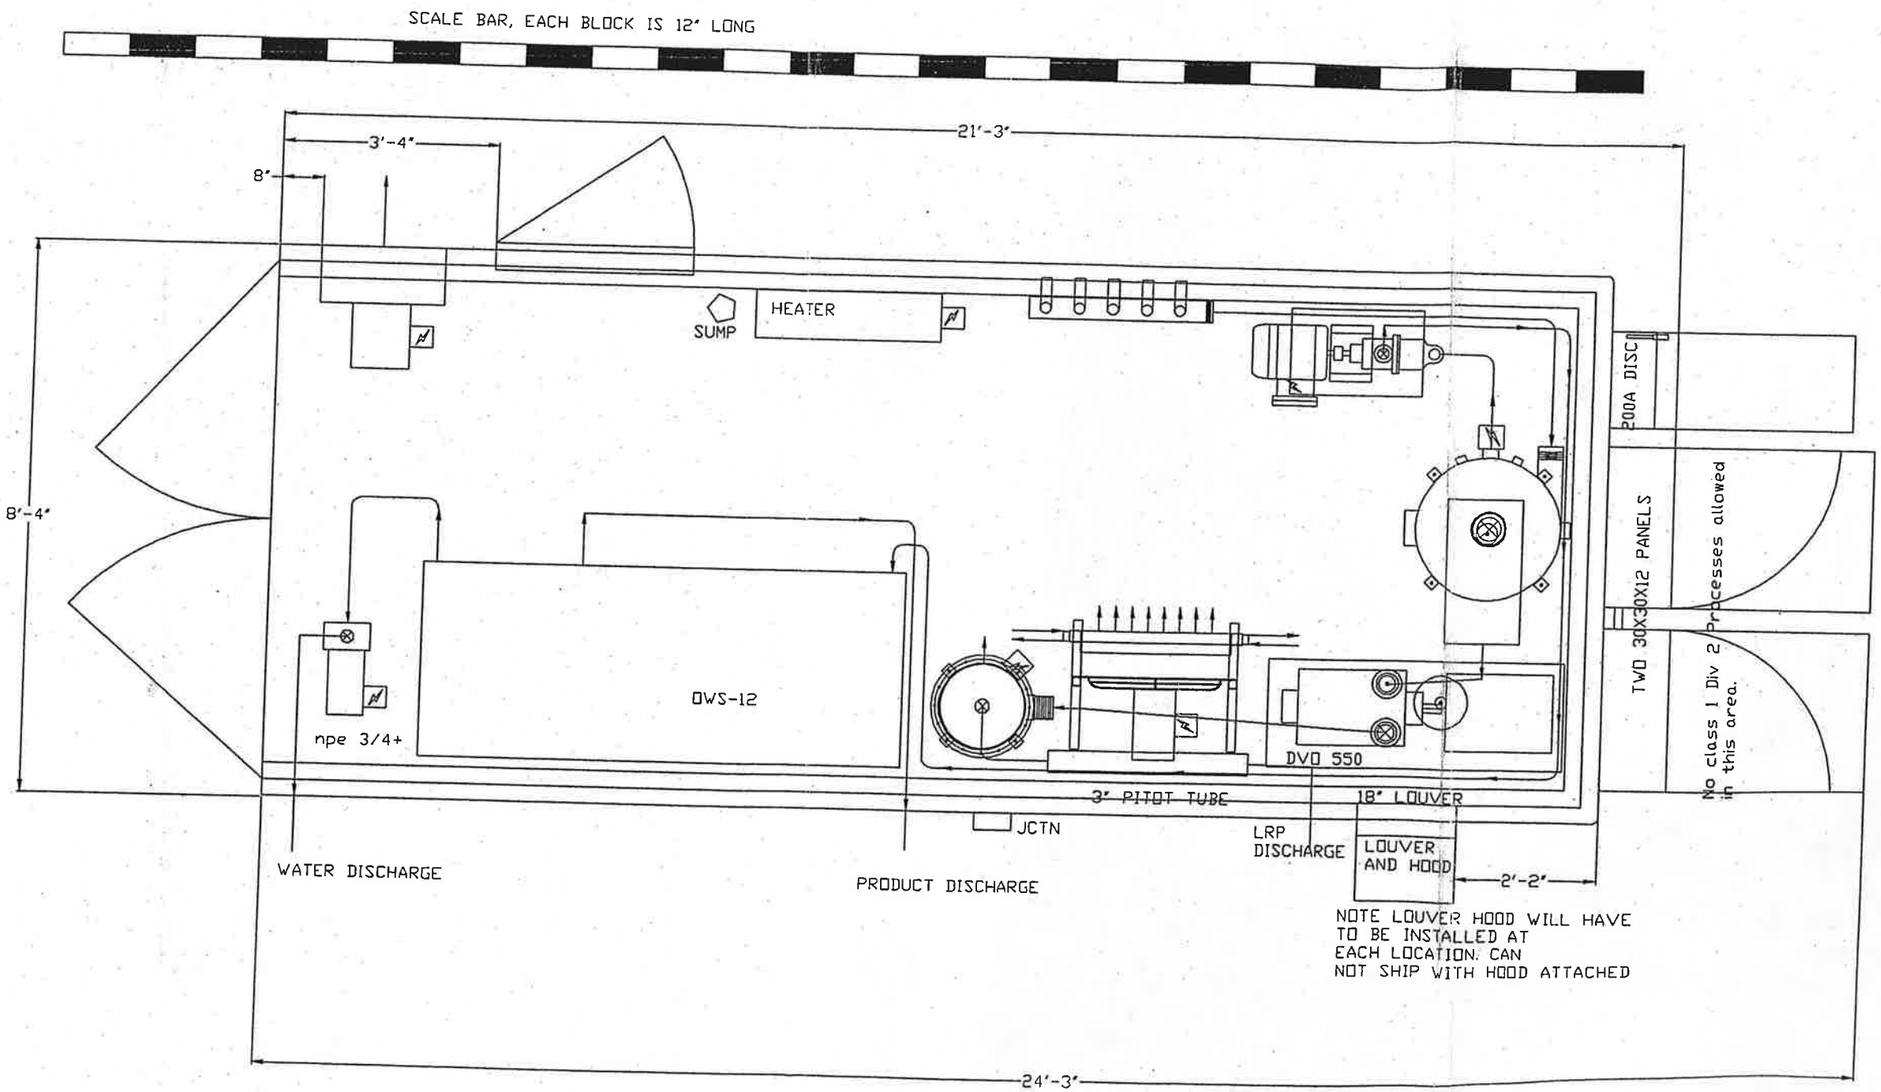

FLOW DIRECTION
FLOW DOWN INTO THE PAGE
FLOW OUT OF THE PAGE
ELECTRICAL CONNECTION
SPACE ALLOCATED FOR SERVICING

LEVEL	DATE	BY	REVISION
C	MAR 5,03	PK	AS BUILT
B	12-2-03	JD	FOR PRODUCTION
A	15-12-03	JD	FOR APPROVAL

MAPLE LEAF ENVIRONMENTAL EQUIPMENT LTD.
TITLE: System Layout
DRAWN BY: JRD
DATE: 15-12-02
CUSTOMER: RAY FREY HWS
APPROVED:
DWG. NO.: R242-02