

STATE OF NEBRASKA)
COUNTY OF HALL) SS


2003 JUN 6 PM 1 17

Notary Public
REG OF DEEDS

CASH _____
CHECK 91.50

REFUNDS:

CASH _____
CHECK _____

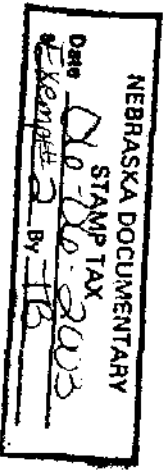

*Heminger Tower
(write pick up)*

Cornhusker Army Ammunition Plant
Hall County, Nebraska

All or Parts of Acquisition Tracts Nos. 14, 26, 27, 28, 57, 58, 59, 60A, 60B, 61 and 109
Tracts 26A, 27A, 37B and 38B

91

QUITCLAIM DEED

KNOW ALL BY THESE PRESENTS:

THIS QUITCLAIM DEED is made this 30th day of May, 2003, by and between the UNITED STATES OF AMERICA, hereinafter referred to as Grantor, acting by and through the Deputy Assistant Secretary of the Army (I&H) pursuant to a delegation of authority from the SECRETARY OF THE ARMY, under and pursuant to the powers and authority contained in Section 2836(a) of the National Defense Authorization Act for Fiscal Year 1995 (Public Law 103-337, 108 Stat 2663, 3063) ("said Act"), and Southern Public Power District, a public corporation and political subdivision of the State of Nebraska, with its principal office located at 4550 West Husker Highway, P.O. Box 1687, Grand Island, Nebraska 68803-1687, hereinafter referred to as Grantee.

WITNESSETH:

WHEREAS, said Act authorizes the Secretary of the Army to convey the property herein to the Hall County, Nebraska, Board of Supervisors, or its designee; and

WHEREAS, said Board designated that the property to be conveyed herein be transferred to Grantee; and

WHEREAS, the property to be conveyed herein has been identified by Grantor pursuant to 42 U.S.C. 9620(h)(4)(A) as real property on which no hazardous substances and no petroleum products or their derivatives were known to have been released or disposed of and appropriate concurrence in such identification has been obtained pursuant to 42 U.S.C. 9620(h)(4)(B); and

WHEREAS, the Grantee's use of the property will be in a manner consistent with the Cornhusker Army Ammunition Plant Reuse Committee Comprehensive Reuse Plan; and

WHEREAS, all the property to be conveyed herein has heretofore been declared surplus to the needs of the United States of America, is presently under the jurisdiction of the Secretary of the Army, is available for disposal and its disposal has been heretofore authorized by the Secretary of the Army, acting pursuant to the above mentioned laws, regulations and orders.

NOW THEREFORE, Grantor and Grantee make the following respective conveyances, grants, assignments, reservations, restrictions, covenants, exceptions, notifications, conditions, and agreements hereinafter set forth.

I. CONVEYANCE

Grantor, for and in consideration of: (1) good and valuable consideration in the sum of One Million Two Hundred Thousand and No/100 Dollars (\$1,200,000.00); the receipt of which is hereby acknowledged by Grantor; and, (2) the specific agreements hereinafter made by Grantee, for himself and his successors and assigns, to abide by and take subject to all reservations, restrictions, covenants, exceptions, notifications, conditions and agreements hereinafter set forth in this Quitclaim Deed, does hereby convey, remise, release and forever quitclaim to the Grantee, his successors and assigns, under and subject to the reservations, restrictions, covenants, exceptions, notifications, conditions and agreements hereinafter set forth, all right, title and interest, in and to the following described property situate, lying, and being in Hall County, State of Nebraska, including any and all buildings, appurtenances and improvements thereon:

Four tracts of land comprising parts of the Sections Eight (8), Seventeen (17), and Twenty (20), Township Eleven (11) North, Range Ten (10) West of the Sixth Principal Meridian, all being in Hall County, Nebraska, containing 743.426 acres, more or less (hereinafter referred to as the "Property"), and being more particularly shown and described on Exhibits "A-1, A-2, A-3 and A-4", which are attached hereto and made a part hereof.

RESERVING, however, to the Grantor, perpetual and assignable easements and rights-of-way, thirty (30) feet in width, in, on, over, and across the property for the installation, operation, use, repair, replacement, and maintenance of a railroad, railroad tracks, ballast, and associated railroad facilities, as shown on Exhibits "A-1" (Tract 26A) and "A-3" (Tract 37B).

RESERVING, however, to the Grantor, ownership and exclusive use of the existing monitoring wells/piezometers located on the property together with access across the property for the purpose of monitoring and/or removing the wells/piezometers. The Grantee, its successors and assigns shall allow ingress and egress of all equipment necessary to accomplish the same. One monitoring well/piezometer is located in the northwest corner of Tract 27A and the other monitoring well/piezometer is located in the southeast corner of Tract 38B.

TO HAVE AND TO HOLD the same, together with all improvements, hereditaments, appurtenances therein and all reversions, remainders, issues, profits and other rights belonging or related thereto, either in law or in equity, for the use, benefit and behalf of the Grantee, his successors and assigns forever.

II. GENERAL GOVERNMENT RESERVATIONS TO CONVEYANCE

This conveyance is expressly made subject to the following reservations in favor of Grantor, and its assigns:

SAVE AND EXCEPT and there is hereby reserved unto Grantor, and its assigns, all rights and interests that have been previously reserved to Grantor in any Patent(s) covering the Property.

III. CERCLA COVENANT AND RESERVED ACCESS

a. Pursuant to Section 120 (h) (4) of the Comprehensive Environmental Response, Compensation, and Liability Act, as amended, 42 U.S.C. Section 9601 et seq. (CERCLA), the Grantor has identified the Property as real property on which no hazardous substances and no petroleum products or their derivatives were known to have been released or disposed of. The Grantor covenants and warrants to the Grantee that in the event that any response action or corrective action is found to be necessary after the date of this conveyance as a result of hazardous substances or petroleum products or their derivatives existing on the Property prior to the date of this conveyance, such response action or corrective action shall be conducted by the Grantor.

b. Grantor reserves a right of access to all portions of the Property for environmental investigation, remediation or other corrective action. This reservation includes the right of access to and use of available utilities at reasonable cost to Grantor. These rights shall be exercisable in any case in which a remedial action, response action or corrective action is found to be necessary after the date of this conveyance, or in which access is necessary to carry out a remedial action, response action, or corrective action on adjoining property. Pursuant to this reservation, Grantor, and its respective officers, agents, employees, contractors and subcontractors shall have the right (upon reasonable notice to the record title owner) to enter upon the Property and conduct investigations and surveys, to include drilling, test-pitting, borings, data and records compilation and other activities related to environmental investigation, and to carry out remedial or removal actions as required or necessary, including but not limited to the installation, operation, and removal of monitoring wells, pumping wells, and treatment facilities. Any such entry, including such activities, responses or remedial actions, shall be coordinated with record title owner and shall be performed in a manner that minimizes interruption with activities of authorized occupants. Grantor will provide the record title owner reasonable advance notice of such activities, responses, or remedial actions. This subparagraph shall not affect the Grantor's future responsibilities, if any, to conduct response actions or corrective actions that are required by applicable laws, rules and regulations.

IV. SPECIFIC ENVIRONMENTAL NOTICES, EXCEPTIONS, RESERVATIONS AND COVENANTS AFFECTING THE PROPERTY

This conveyance is expressly made subject to the following environmental notices, exceptions, reservations, and covenants affecting the property hereby conveyed to the extent and only to the extent the same are valid and affect the property, and shall be considered as covenants running with the land and binding on all parties having any right, title or interest in the property, or any part thereof, their heirs, successors and assigns.

a. Federal Facility Agreement

The Grantee acknowledges that Cornhusker Army Ammunition Plant has been identified as a National Priority List (NPL) site under the Comprehensive, Environmental, Response, Compensation and Liability Act (CERCLA) of 1980, as amended. A copy of the Cornhusker Army Ammunition Plant Federal Facility Agreement (FFA), entered into by the United States Environmental Protection Agency (EPA) Region VII, the State of Nebraska, and the Department of the Army, effective September 1990, and a copy of any amendments thereto, are available for the Grantee's review at the Office of the Commander's Representative. The Grantee agrees that should any conflict arise between the terms of the FFA as they presently exist or may be amended, and the provisions of this property transfer, the terms of the FFA will take precedence. The Grantee further agrees that notwithstanding any other provisions of the property transfer, the United States assumes no liability to the person or entity to whom the property is transferred should implementation of the FFA interfere with their use of the property. The Grantee or any subsequent transferee, shall have no claim on account of any such interference against the United States or any officer, agent, employee or contractor thereof.

b. Environmental Baseline Survey (EBS) and Finding of Suitability to Transfer (FOST)

1. The Grantee has received the technical environmental reports, including the Environmental Baseline Survey for the Property dated 9-20 November 1998, as amended by Amendment No. 1, signed April 2002, and the FOST for the property dated November 2002, prepared by the Grantor, and agrees, to the best of the Grantee's knowledge, that they accurately describe the environmental condition of the Property. The Grantee has inspected the Property and accepts the physical condition and current level of environmental hazards on the Property and deems the Property to be safe for the Grantee's intended use.

2. If an actual or threatened release of a hazardous substance or petroleum product is discovered on the Property after the date of the conveyance, whether or not such substance was set forth in the technical environmental reports, including the EBS, Grantee or its successors or assigns shall be responsible for such release or newly discovered substance unless Grantee is able to demonstrate that such release or such newly discovered substance was due to Grantor's activities, ownership, use, or occupation of the Property. Grantee, its successors and assigns, as consideration for the conveyance, agree to release Grantor from any liability or responsibility for

200307151

any claims arising solely out of the release of any hazardous substance or petroleum product on the Property occurring after the date of this Deed, where such substance or product was placed on the Property by the Grantee, or its successors, assigns, employees, invitees, agents or contractors, after the conveyance. This Subsection IV.b. shall not affect the Grantor's responsibilities to conduct response actions or corrective actions that are required by applicable laws, rules and regulations.

c. Polychlorinated Biphenyls (PCBs) Containing Equipment Notification

The Grantee is hereby informed and does acknowledge that equipment containing polychlorinated biphenyls (PCBs) exists on the property being conveyed. Southern Public Power District (SPPD) owns said equipment.

V. GENERAL EXCEPTIONS TO CONVEYANCE

This conveyance is expressly made subject to the following matters to the extent and only to the extent the same are valid and affect the Property:

a. All existing permits, easements and rights-of-way for public streets, roads and highways, public utilities, electric power lines, electric transmission facilities, recreational trails, railroads, pipelines, ditches and canals on, over and across said land, whether or not of record, including but not limited to the following:

1. Easement DACA45-2-99-6157 granted to Hall County for road rights-of-way.
2. Easement DACA45-2-00-6023 granted to Hall County for road rights-of-way.
3. Easement DACA45-2-97-6024 granted to Southern Nebraska Rural Public Power District for overhead electric power lines.
4. Easement DACA45-2-01-6078 granted to City of Grand Island for recreation trail rights-of-way. Grantee is not permitted to disturb the area lying within the recreation trail easement.

b. Any zoning laws, ordinances, or regulations governing the subject property or regulations of other regulatory authorities having jurisdiction.

c. Matters which would be disclosed by a careful physical inspection of the property or the property records and by a properly conducted survey of the property.

d. Any survey discrepancies, conflicts, or shortages in area or boundary lines, or any encroachments, or protrusions, or any overlapping of improvements that may affect the property.

e. All existing interest(s) reserved to or outstanding in third parties in and to coal, oil, gas, and/or minerals.

f. All other existing interests reserved by any original Grantor(s) in chain of title unto said Grantor(s), their respective successors and assigns, which affects any portion of the property interest(s) hereinabove described.

g. Installation commander agreements, whether or not of record or otherwise approved in writing by Grantee.

VI. MISCELLANEOUS GRANTEE COVENANTS

Grantee covenants for himself, and his successors or assigns, and every successor in interest in the Property, to abide with each of the agreements and covenants running with the land described in Section IV of this Quitclaim Deed. In addition, Grantor and its assigns shall be deemed a beneficiary of each of the following agreements and covenants without regard to whether it remains the owner of any land or interest therein in the locality of the Property hereby conveyed and shall have a right to enforce each of the following agreements and covenants in any court of competent jurisdiction. Notwithstanding the foregoing, Grantor, and its assigns shall have no affirmative duty to any successor in title to this conveyance to enforce any of the following agreements and covenants.

a. It is understood and agreed by Grantee, for himself and his successors and assigns, that the Property is conveyed "*as is*" and "*where is*" without any representation or warranty on the part of Grantor to make any alterations, repairs or additions. Grantor shall not be liable for any latent or patent defects in the Property. Grantee, for himself and his successors and assigns, acknowledges that Grantor has made no representations or warranty concerning the condition and state of repair of the Property nor in any agreement or promise to alter, improve, adapt or repair the Property.

b. The Grantee shall neither transfer the property, lease the property, nor grant any interest, privilege, or license whatsoever in connection with the property without the inclusion of the environmental protection provisions set out in Section IV herein, and shall require the inclusion of such environmental protection provisions in all further deeds, transfers, leases, or grant of any interest, privilege, or license.

VII. AGREEMENTS, NOTICES AND CONDITIONS

a. Non-Discrimination

With respect to activities related to the property, the Grantee hereby agrees that it will comply with the requirements of Title VI of the Civil Rights Act of 1964 (Public Law No. 88-352) and all requirements imposed by or pursuant to the regulations issued pursuant to the Act and now in effect, to the end that, in accordance with said Act and regulations, no person in the United States shall, on the ground of race, color, national origin, sex, or handicap be excluded from participation in, be denied the benefits of, or otherwise be subjected to discrimination under any program or activity related to the property of the Grantee, its successors or assigns.

200307151

b. Anti-Deficiency Act

The Grantor's obligation to pay or reimburse any money under this Deed is subject to the availability of appropriated funds to the Department of the Army, and nothing in this deed shall be interpreted to require obligations or payment by the Grantor in violation of the Anti-Deficiency Act.

c. Wetlands Notice

A portion the property contains wetlands.


THIS QUITCLAIM DEED is exempt from the documentary tax under the provision of Neb. Rev. Stat. 76-902(2) (R.S. Supp., 1991) in which property is transferred by the United States.

THIS QUITCLAIM DEED is not subject to the provisions of 10 U.S.C. 2662.

- R1 - RECORDED DISTANCE AND/OR ANGLE ON SURVEY BY RONALD R. ROCKWELL, L. S. NO. 340, DATED JANUARY 24, 2001 (PARCEL NO. 1)
- R2 - RECORDED DISTANCE AND/OR ANGLE ON SURVEY BY RONALD R. ROCKWELL, L. S. NO. 348, DATED JANUARY 24, 2001 (PARCEL NO. 4)
- R3 - RECORDED DISTANCE ON SECTION CORNER TIE SHEET BY DANIEL J. HOSTLER, COUNTY SURVEYOR, L. S. NO. 263, DATED MARCH 24, 1999
- A - ACTUAL DISTANCE AND/OR ANGLE

200307151

- = INDICATES 1/2" IRON PIPE FOUND
- = INDICATES 1/2" IRON PIPE PLACED

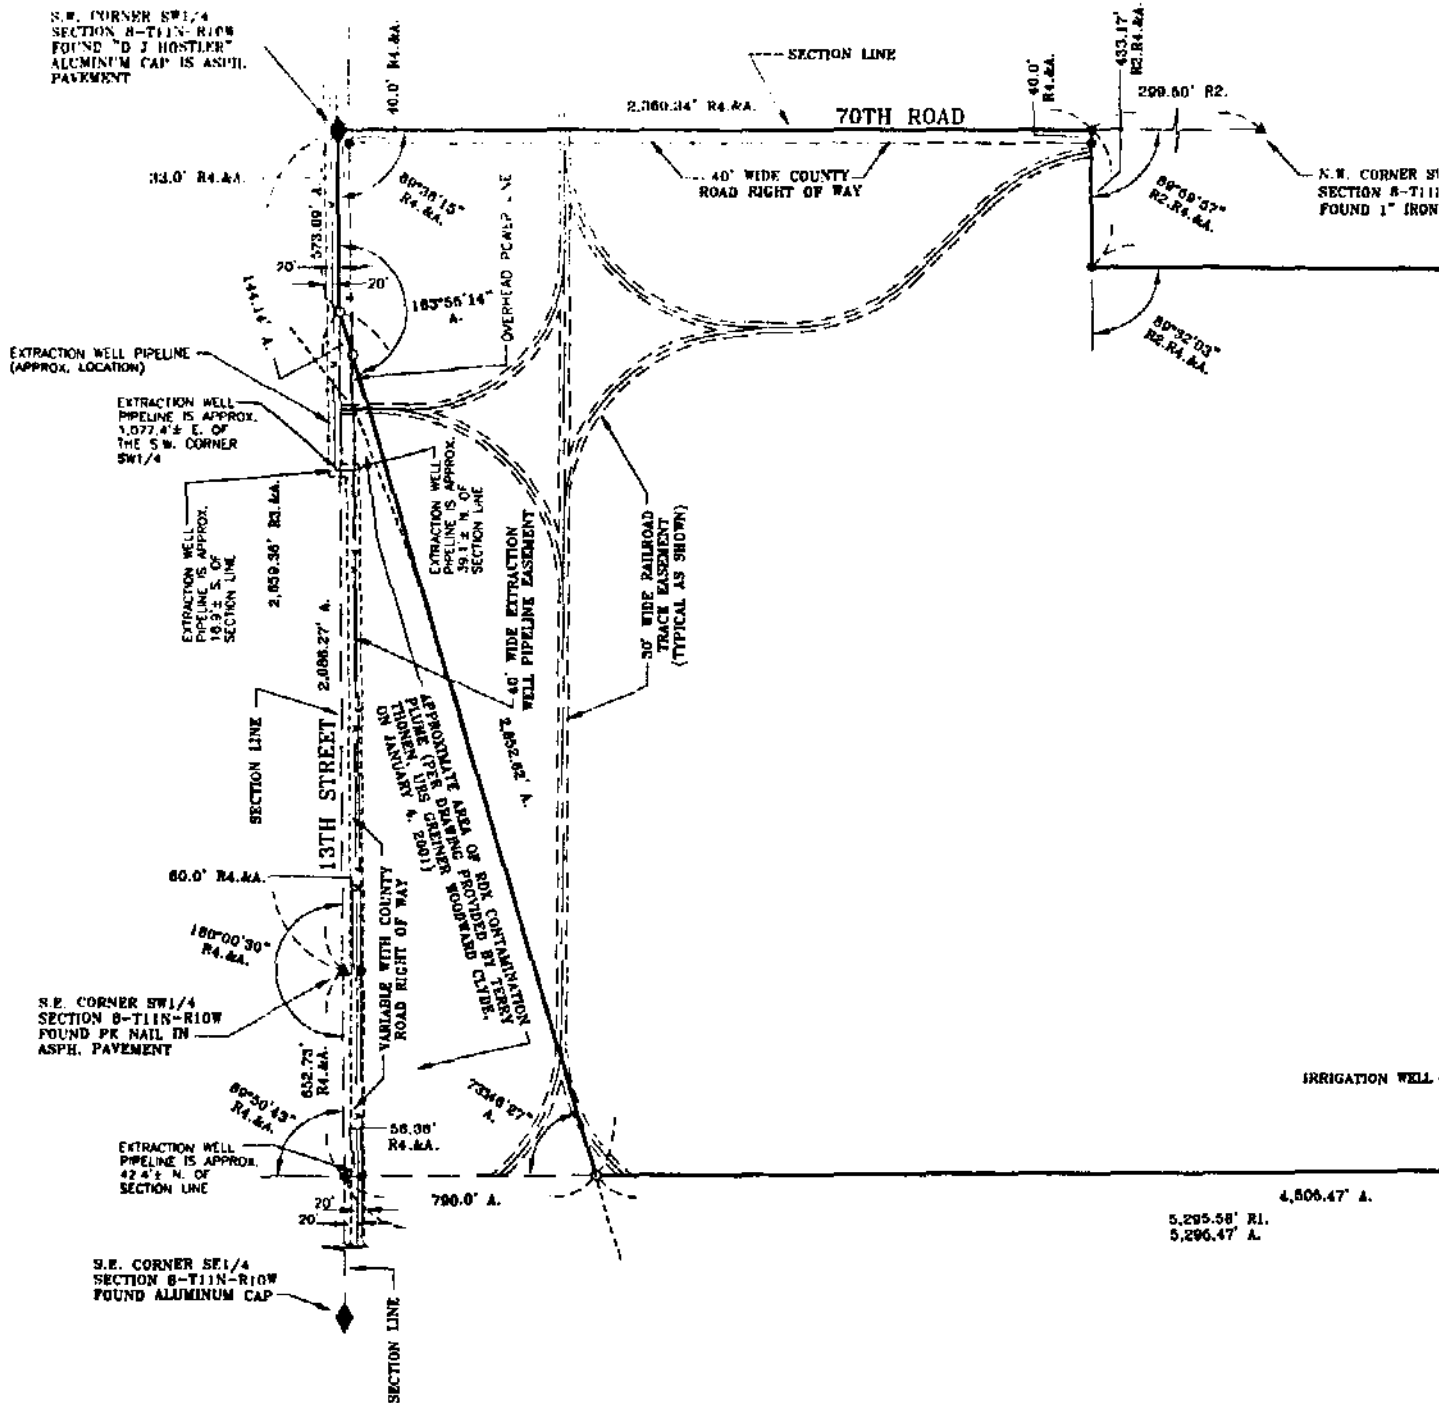


LEGAL DESCRIPTION

A tract of land comprising a part of the Southwest Quarter (SW1/4), part of the Northwest Quarter (NW1/4), part of the Northeast Quarter (NE1/4), and a part of the Southeast Quarter (SE1/4), all being in Section Eight (8), Township Eleven (11) North, Range Ten (10) West of the 8th P.M., Hall County, Nebraska, and more particularly described as follows:

Beginning at the southwest corner of said Southwest Quarter (SW1/4); thence running northerly, along and upon the west line of said Southwest Quarter (SW1/4), a distance of Two Thousand Three Hundred Sixty and Thirty Four Hundredths (2,360.34) feet; thence deflecting right 89°59'57" and running easterly, a distance of Four Hundred Thirty Three and Seventeen Hundredths (433.17) feet; thence deflecting left 89°32'03" and running northerly, a distance of Two Thousand Nine Hundred Fifty Seven and Thirty One Hundredths (2,957.31) feet to a point on the north line of said Northwest Quarter (NW1/4), said point being Four Hundred Fifty Seven and Fifty Four Hundredths (457.54) feet east of the northwest corner of said Northwest Quarter (NW1/4); thence deflecting right 89°31'07" and running easterly, along and upon the north line of said Northwest Quarter (NW1/4), a distance of Two Thousand Two Hundred Eleven and Sixty Seven Hundredths (2,211.57) feet to the northwest corner of said Northeast Quarter (NE1/4); thence deflecting right 89°01'10" and running easterly, along and upon the north line of said Northeast Quarter (NE1/4), a distance of Six Hundred Twenty and Forty Seven Hundredths (620.47) feet; thence deflecting right 89°44'41" and running southerly, a distance of Four Thousand Five Hundred Five and Forty Seven Hundredths (4,505.47) feet to a point, said point being Seven Hundred Ninety (700.0) feet north of (as measured along and upon the southerly prolongation of the aforementioned course) the south line of said Southeast Quarter (SE1/4); thence deflecting right 70°48'27" and running southwesterly, a distance of Two Thousand Eight Hundred Fifty Two and Sixty Two Hundredths (2,852.62) feet to a point on the south line of said Southwest Quarter (SW1/4), said point being Two Thousand Eighty Six and Twenty Seven Hundredths (2,086.27) feet west of the southeast corner of said Southwest Quarter (SW1/4); thence deflecting right 18°04'46" and running westerly, along and upon the south line of said Southwest Quarter (SW1/4), a distance of Five Hundred Seventy Three and Nine Hundredths (573.09) feet to the point of beginning and containing 347.070 acres, more or less.

200307151

SCALE 1"=300'

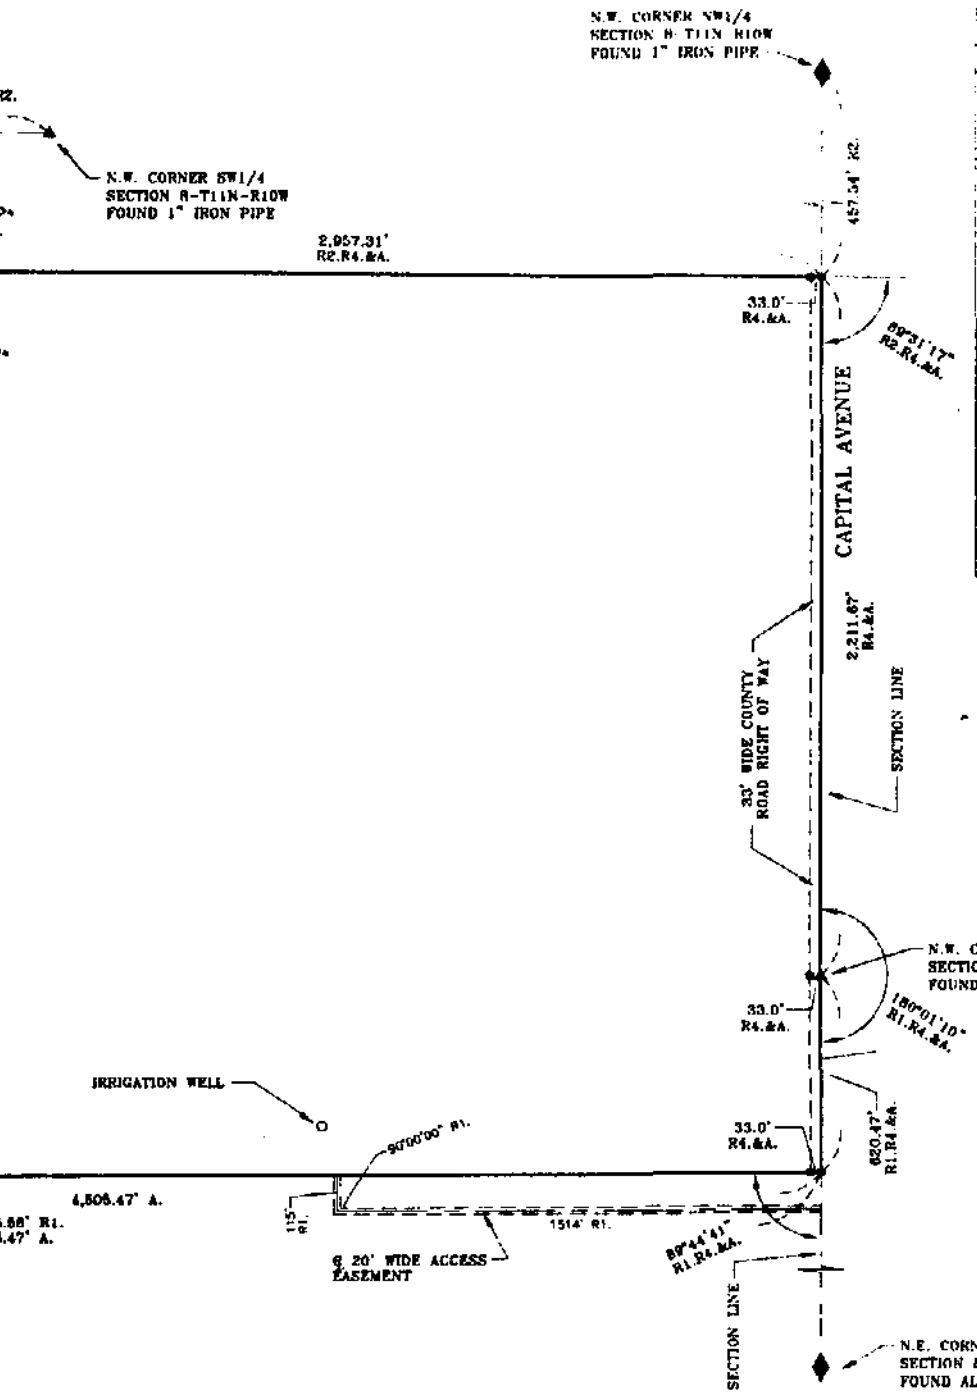

CORNER TIES

- N.E. CORNER NE1/4 - FOUND ALUMINUM CAP
 - 48.10' N.E. TO NAIL IN TELEPHONE POLE
 - 47.00' N.E. TO NAIL IN POWER POLE
 - 48.48' N.W. TO NAIL IN POWER POLE
- N.W. CORNER NE1/4 - FOUND 1/2" IRON PIPE
 - 71.74' N.W. TO NAIL IN 10" TREE
 - 89.22' N.E. TO NAIL IN 10" TREE
 - 81.10' N.N.W. TO NAIL IN 8" TREE
- N.W. CORNER NW1/4 - FOUND 1" IRON PIPE
 - 73.85' S.W. TO NAIL IN POWER POLE
 - 88.75' S.E. TO NAIL IN 6" TREE
 - 73.89' N.E. TO NAIL IN 14" TREE
- N.W. CORNER SW1/4 - FOUND 1" IRON PIPE
 - 12.88' N.W. TO NAIL IN POWER POLE
 - 14.50' W. TO 1/2" IRON PIPE
 - 14.50' E. TO 1/2" IRON PIPE
- S.W. CORNER SW1/4 - FOUND "D J HOSTLER" ALUMINUM CAP IN ASPH. PAVEMENT
 - 74.45' N.W. TO NAIL IN POWER POLE
 - 35.90' S.S.E. TO 1/2" IRON PIPE
 - 74.21' N.E. TO 1/2" IRON PIPE
- S.E. CORNER SW1/4 - FOUND PE NAIL IN ASPH. PAVEMENT
 - 88.40' S.W. TO NAIL IN 20" TREE
 - 38.40' S.E. TO NAIL IN 12" TREE
 - 68.40' N.E. TO NAIL IN POWER POLE
- S.E. CORNER SE1/4 - FOUND ALUMINUM CAP
 - 81.08' N.W. TO NAIL IN FENCE BRACE POST
 - 81.28' S.E. TO NAIL IN POWER POLE
 - 48.49' N.E. TO TOP CENTER OF FIRE HYDRANT

SURVEYOR'S CERTIFICATE

I hereby certify that to the best of my knowledge and belief, the accompanying plat is from an accurate survey of the described property made under my supervision.

Lee D. Wagner, Registered Land Surveyor No. 557

PT. OF THE SW1/4, PT. OF THE NW1/4,
PT. OF THE NE1/4, & PT. OF THE SE1/4
SECTION 8-T11N-R10W
HALL COUNTY, NEBRASKA

LAND SURVEY

BENJAMIN & ASSOCIATES, INC.
ENGINEERS & SURVEYORS
P. O. BOX 328 PHONE 382-8488 AREA CODE 308
GRAND ISLAND, NEBRASKA 68802-0328


TRACT NO. 26A

EXHIBIT "A-1" ATTACHED TO AND MADE

A PART OF QUITCLAIM DEED

RECORDED DISTANCE AND/OR ANGLE ON SURVEY BY RONALD R. ROCKWELL,
 L. S. NO. 349, DATED JANUARY 24, 2001 (PARCEL NO. 1)
 RECORDED DISTANCE AND/OR ANGLE ON SURVEY BY LEE D. WAGNER,
 S. NO. 657, DATED AUGUST 28, 2002 (TRACT NO. 27)
 A - ACTUAL DISTANCE AND/OR ANGLE

● = INDICATES 1/2" IRON PIPE FOUND
 ○ = INDICATES 1/2" IRON PIPE PLACED

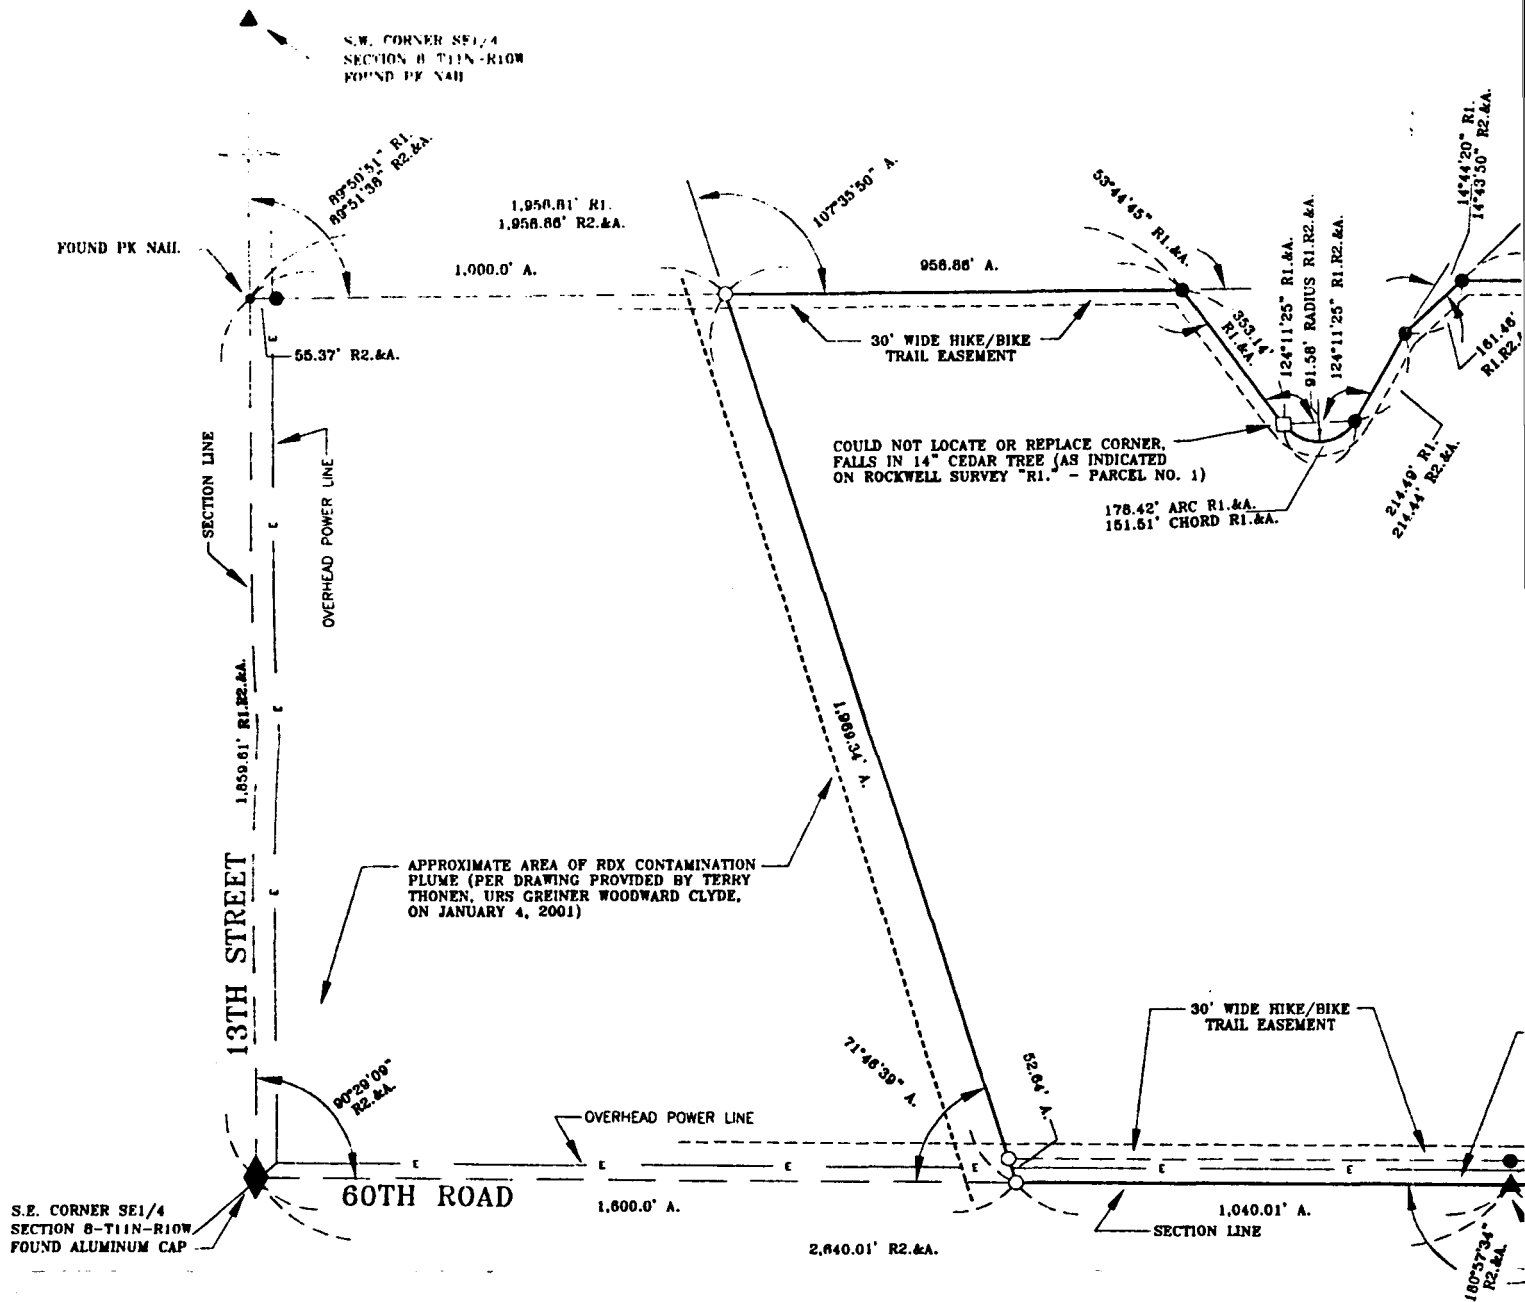

LEGAL DESCRIPTION

A tract of land comprising a part of the Southeast Quarter (SE1/4) and a part of the Northeast Quarter (NE1/4), all being in Section Eight (8), Township Eleven (11) North, Range Ten (10) West of the 8th P.M., Hall County, Nebraska, and more particularly described as follows:

Beginning at the northeast corner of said Southeast Quarter (SE1/4); thence running southerly, along and upon the east line of said Southeast Quarter (SE1/4), a distance of One Thousand Forty and One Hundredth (1,040.01) feet to a point, said point being One Thousand Six Hundred (1,600.0) feet north of the southeast corner of said Southeast Quarter (SE1/4); thence deflecting right 71°48'39" and running southwesterly, a distance of One Thousand Nine Hundred Sixty Nine and Thirty Four Hundredths (1,969.34) feet; thence deflecting right 107°35'50" and running northerly, a distance of Nine Hundred Fifty Eight and Eighty Six Hundredths (958.86) feet; thence deflecting right 53°44'45" and running northeasterly, a distance of Three Hundred Fifty Three and Fourteen Hundredths (353.14) feet to a point of curvature; thence running northerly, along and upon the arc of a curve to the left whose radius is 91.58 feet, a distance of One Hundred Seventy Eight and Forty Two Hundredths (178.42) feet (long chord distance = 161.51, long chord deflecting left 55°48'35" from the previously described course) to a point of tangency; thence deflecting left 55°48'35" from the chord of the previously described curve and running northwesterly, a distance of Two Hundred Fourteen and Forty Four Hundredths (214.44) feet; thence deflecting right 14°43'50" and running northwesterly, a distance of One Hundred Sixty One and Forty Six Hundredths (161.46) feet; thence deflecting right 13°30'38" and running northerly, a distance of One Thousand Three Hundred Sixty Four and Forty Nine Hundredths (1,364.49) feet; thence deflecting right 80°15'22" and running easterly, a distance of One Thousand Eight Hundred Eighty Five and Thirty One Hundredths (1,885.31) feet to a point on the east line of said Northeast Quarter (NE1/4); thence deflecting right 89°02'42" and running southerly, along and upon the east line of said Northeast Quarter (NE1/4), a distance of One Thousand Two Hundred Fifty Nine and Sixty Six Hundredths (1,259.66) feet to the point of beginning and containing 120.317 acres, more or less.


SURVEYOR'S CERTIFICATE

I hereby certify that to the best of my knowledge and belief, the accompanying plat is from an accurate survey of the described property made under my supervision.

Lee D. Wagner
 Lee D. Wagner, Registered Land Surveyor No. 657

SCALE 1"=200'

200307151

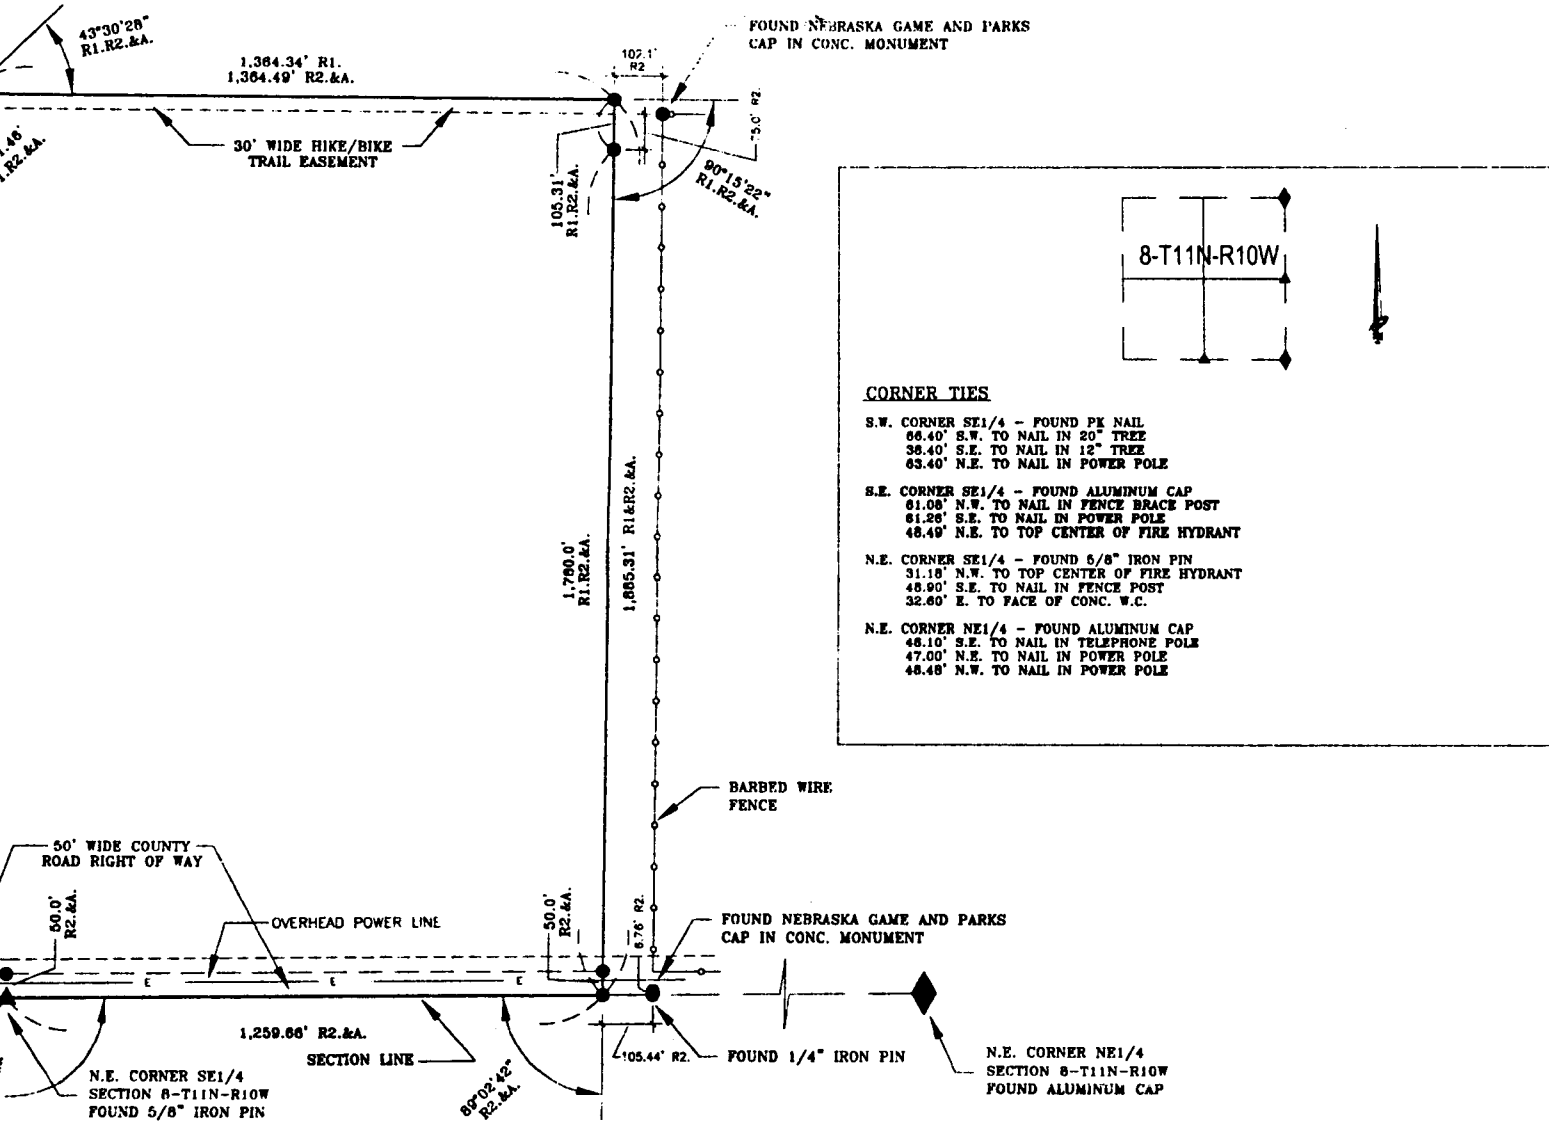

8-T11N-R10W

CORNER TIES

S.W. CORNER SE1/4 - FOUND PK NAIL
 66.40' S.W. TO NAIL IN 20" TREE
 36.40' S.E. TO NAIL IN 12" TREE
 63.40' N.E. TO NAIL IN POWER POLE

S.E. CORNER SE1/4 - FOUND ALUMINUM CAP
 61.08' N.W. TO NAIL IN FENCE BRACE POST
 48.49' N.E. TO TOP CENTER OF FIRE HYDRANT

N.E. CORNER SE1/4 - FOUND 5/8" IRON PIN
 31.18' N.W. TO TOP CENTER OF FIRE HYDRANT
 48.90' S.E. TO NAIL IN FENCE POST
 32.80' E. TO FACE OF CONC. W.C.

N.E. CORNER NE1/4 - FOUND ALUMINUM CAP
 48.10' S.E. TO NAIL IN TELEPHONE POLE
 47.00' N.E. TO NAIL IN POWER POLE
 48.48' N.W. TO NAIL IN POWER POLE

PART OF THE SE1/4 AND
 PART OF THE NE1/4
 SECTION 8-T11N-R10W
 HALL COUNTY, NEBRASKA

LAND SURVEY

BENJAMIN & ASSOCIATES, INC.
 ENGINEERS & SURVEYORS
P. O. BOX 330 PHONE 382-8485 - AREA CODE 308
 GRAND ISLAND, NEBRASKA 68802-0330

TRACT NO. 27A

EXHIBIT "A-2" ATTACHED TO AND MADE
 A PART OF QUITCLAIM DEED


200307151

SCALE 1"=300'

S.W. CORNER SW1/4
SECTION 17-T11N-R10W
FOUND "D J HOSTLER"
ALUMINUM CAP IS ASPH.
PAVEMENT

- R1. - RECORDED DISTANCE AND/OR ANGLE ON SURVEY BY RONALD R. ROCKWELL, L. S. NO. 349, DATED JUNE 29, 2000 (PARCEL NO. 7)
- R2. - RECORDED DISTANCE AND/OR ANGLE ON SURVEY BY LEE D. WAGNER, L. S. NO. 557, DATED JULY 27, 2001 (TRACT NO. 50A)
- R3. - RECORDED DISTANCE AND/OR ANGLE ON SURVEY BY LEE D. WAGNER, L. S. NO. 557, DATED AUGUST 28, 2001 (TRACT NO. 26)
- A. - ACTUAL DISTANCE AND/OR ANGLE




● = INDICATES 1/2"
○ = INDICATES 1/2"

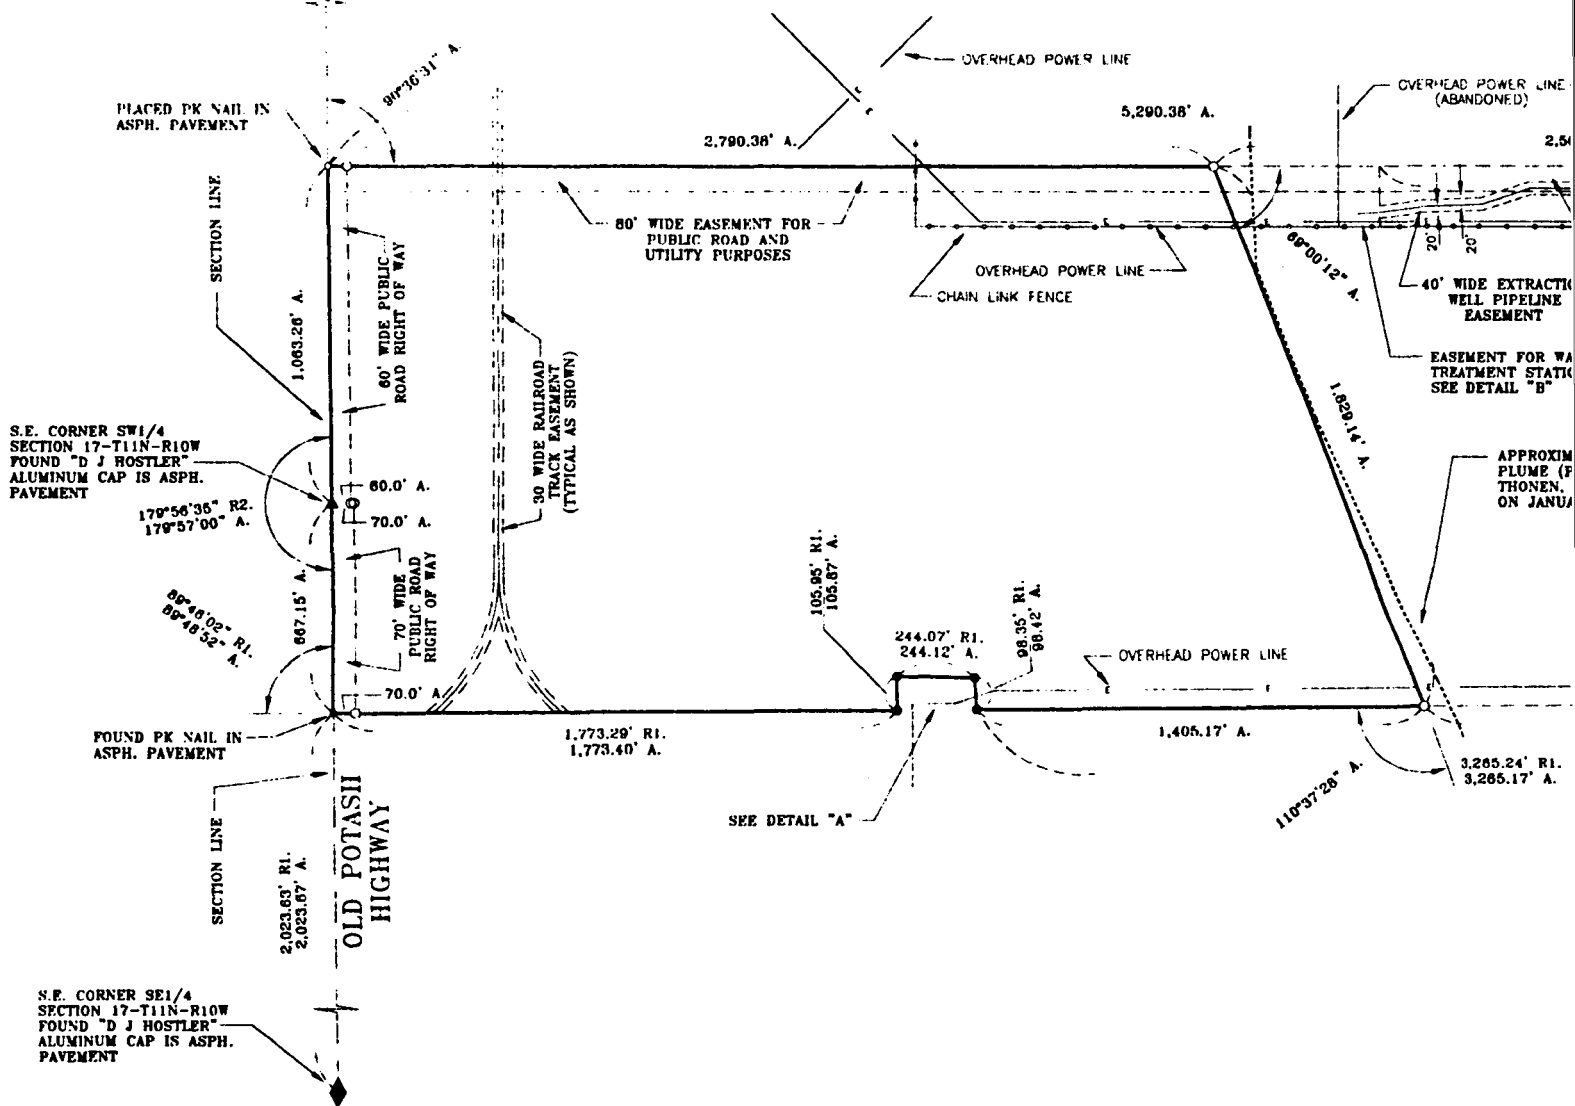

17-T11N-R10W

CORNER TIES

- N.W. CORNER NW1/4 - FOUND "D J HOSTLER" ALUMINUM CAP IN ASPH. PAVEMENT
74.45' N.W. TO NAIL IN POWER POLE
35.90' S.S.E. TO 1/2" IRON PIPE
74.21' N.E. TO 1/2" IRON PIPE
- N.E. CORNER NE1/4 - FOUND PK NAIL
66.40' S.W. TO NAIL IN 20" TREE
39.40' S.E. TO NAIL IN 12" TREE
63.40' N.E. TO NAIL IN POWER POLE
- N.E. CORNER NE1/4 - FOUND ALUMINUM CAP
61.26' N.W. TO NAIL IN FENCE BRACE POST
61.26' S.E. TO NAIL IN POWER POLE
48.49' N.E. TO TOP CENTER OF FIRE HYDRANT
- S.E. CORNER SE1/4 - FOUND "D J HOSTLER" ALUMINUM CAP IN ASPH. PAVEMENT
70.98' N.W. TO NAIL IN FENCE CORNER POST
72.20' S.W. TO NAIL IN FENCE CORNER POST
64.50' S.E. TO "X" NAILS IN FENCE CORNER POST
- S.W. CORNER SW1/4 - FOUND "D J HOSTLER" ALUMINUM CAP IN ASPH. PAVEMENT
67.00' S.W. TO NAIL IN 18" TREE
78.90' S.S.W. TO NAIL IN POWER POLE
57.20' N.E. TO NAIL IN 8" TREE
- S.W. CORNER SW1/4 - FOUND "D J HOSTLER" ALUMINUM CAP IN ASPH. PAVEMENT
79.20' N.W. TO NAIL IN POWER POLE
48.05' S.W. TO "X" NAILS IN POWER GUY POLE
95.20' N.E. TO NAIL IN POWER POLE

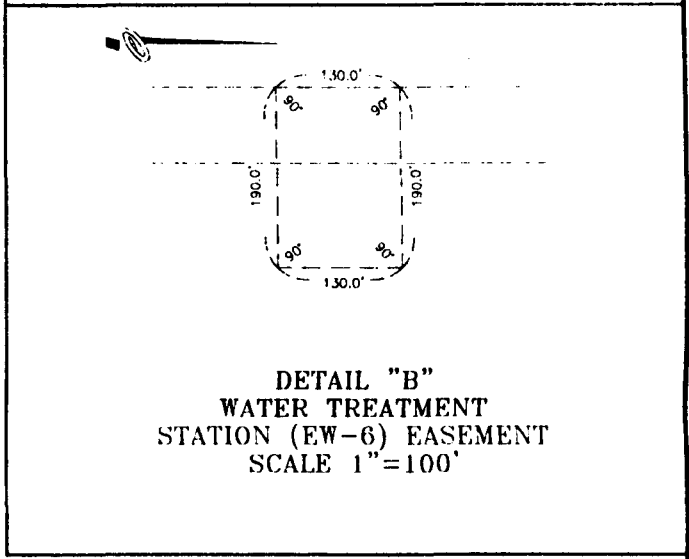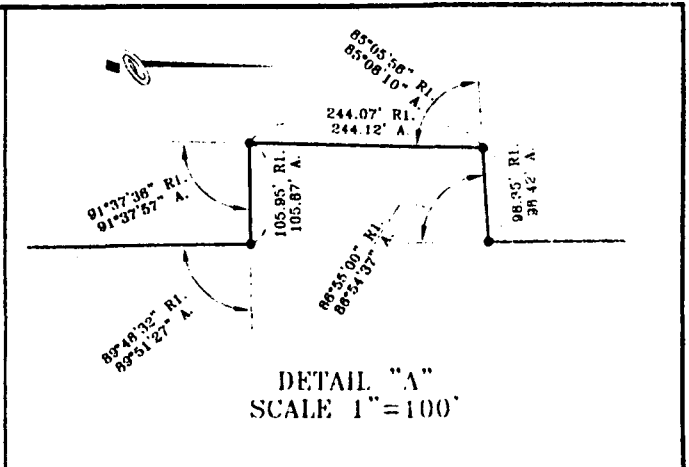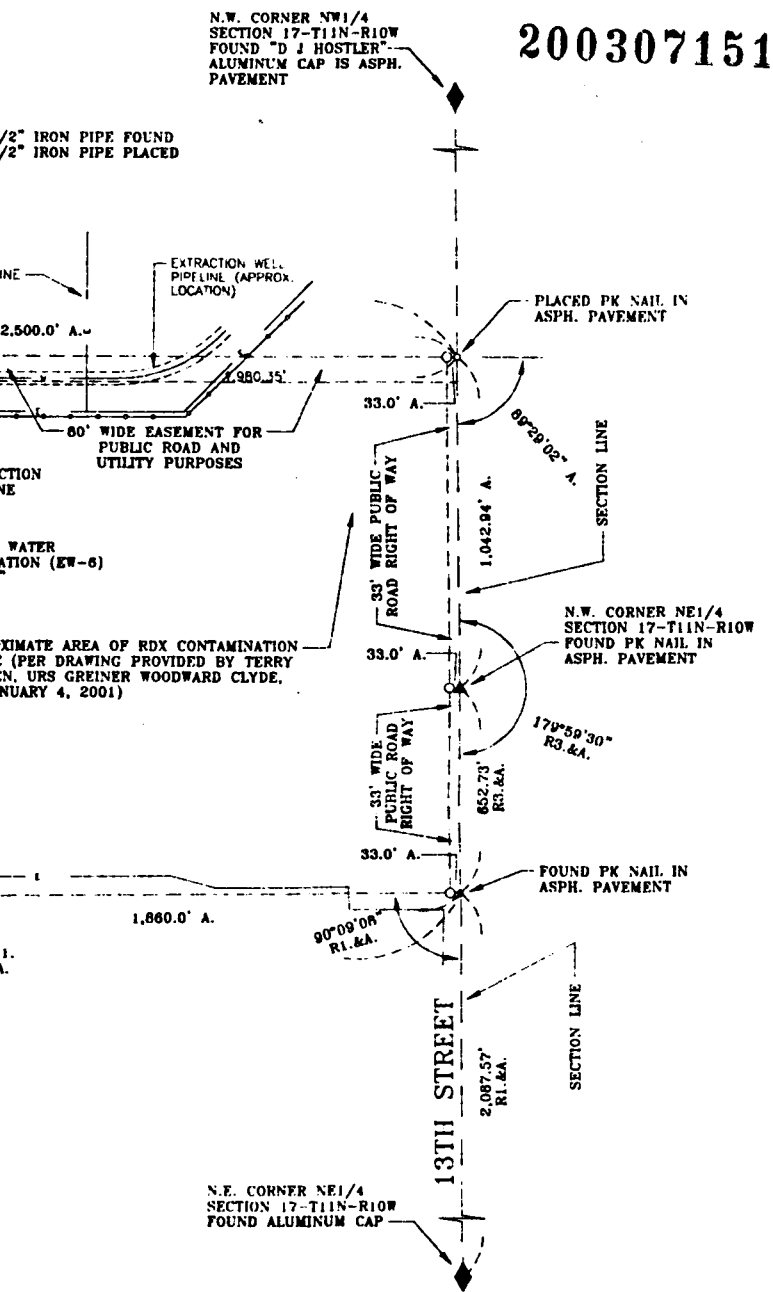

LEGAL DESCRIPTION

A tract of land comprising a part of the Southwest Quarter (SW1/4), a part of the Northwest Quarter (NW1/4), a part of the Northeast Quarter (NE1/4), and a part of the Southeast Quarter (SE1/4), all being in Section Seventeen (17), Township Eleven (11) North, Range Ten (10) West of the 6th P.M., Hall County, Nebraska, and more particularly described as follows:

Beginning at the southeast corner of said Southwest Quarter (SW1/4), thence running westerly, along and upon the south line of said Southwest Quarter (SW1/4), a distance of One Thousand Sixty Three and Twenty Six Hundredths (1,063.26) feet; thence deflecting right 90°38'31" and running northerly, a distance of Two Thousand Seven Hundred Ninety and Thirty Eight Hundredths (2,790.38) feet; thence deflecting right 89°00'12" and running northeasterly, a distance of One Thousand Eight Hundred Twenty Nine and Fourteen Hundredths (1,829.14) feet; thence deflecting right 110°37'28" and running southerly, a distance of One Thousand Four Hundred Five and Seventeen Hundredths (1,405.17) feet; thence deflecting right 86°54'37" and running westerly, a distance of Ninety Eight and Forty Two Hundredths (98.42) feet; thence deflecting left 86°08'10" and running southerly, a distance of Two Hundred Forty Four and Twelve Hundredths (244.12) feet; thence deflecting left 91°37'57" and running easterly, a distance of One Hundred Five and Eighty Seven Hundredths (105.87) feet; thence deflecting right 89°51'27" and running southerly, a distance of One Thousand Seven Hundred Seventy Three and Four Tenths (1,773.40) feet to a point on the south line of said Southeast Quarter (SE1/4), said point being Two Thousand Twenty Three and Sixty Seven Hundredths (2,023.67) feet west of the southeast corner of said Southeast Quarter (SE1/4); thence deflecting right 89°48'52" and running westerly, along and upon the south line of said Southeast Quarter (SE1/4), a distance of Six Hundred Sixty Seven and Fifteen Hundredths (667.15) feet to the point of beginning and containing 122.210 acres, more or less.

SURVEYOR'S CERTIFICATE

I hereby certify that to the best of my knowledge and belief, the accompanying plat is from an accurate survey of the described property made under my supervision.

Lee D. Wagner
Lee D. Wagner, Registered Land Surveyor No. 557

PT. OF THE SW1/4, PT. OF THE NW1/4, PT. OF THE NE1/4, & PT. OF THE SE1/4 SECTION 17-T11N-R10W HALL COUNTY, NEBRASKA	2003 01-21-2003 I W 2003
LAND SURVEY	
BENJAMIN & ASSOCIATES, INC. ENGINEERS & SURVEYORS P. O. BOX 339 PHONE 382-8485 - AREA CODE 300 GRAND ISLAND, NEBRASKA 68802-0339	

TRACT NO. 37B

EXHIBIT "A-3" ATTACHED TO AND MADE
 A PART OF QUITCLAIM DEED


200307151

OLD POTASH HWY.

- R1. - RECORDED DISTANCE ON QUITCLAIM DEED (PARCEL NO. 3 - NEBRASKA GAMES AND PARKS COMMISSION) IN DEED BOOK 186, PAGE 443, HALL COUNTY REGISTER OF DEEDS OFFICE
- R2. - RECORDED DISTANCE AND/OR ANGLE ON SURVEY BY RONALD R. ROCKWELL, S. NO. 349, DATED JANUARY 24, 2001 (PARCEL NO. 7)
- R3. - RECORDED DISTANCE AND/OR ANGLE ON SURVEY BY RONALD R. ROCKWELL, S. NO. 349, DATED JANUARY 24, 2001 (PARCEL NO. 2)
- R4. - RECORDED DISTANCE AND/OR ANGLE ON PLAT OF CORNHUSKER SUBDIVISION
- R5. - RECORDED DISTANCE ON DRAWINGS OF GAS LINE EASEMENT PROVIDED BY JO SHORT, CORNHUSKER AAP OFFICE
- R6. - RECORDED DISTANCE AND/OR ANGLES ON SURVEY BY LEE D. WAGNER, L. S. NO. 557, DATED AUGUST 28, 2001
- A. - ACTUAL DISTANCE AND/OR ANGLE

● = INDICATES 1/2" IRON PIPE FOUND
 ○ = INDICATES 1/2" IRON PIPE PLACED

CORNER TIES
 N.W. CORNER NE1/4 OF SECTION 20-T11N-R10W - FOUND IN ASPH. PAVEMENT
 87.00' S.W. TO NAIL IN 18" TREE
 78.00' S.E.W. TO NAIL IN POWER POLE
 67.20' N.E. TO NAIL IN 8" TREE
 S.E. CORNER NE1/4 OF SECTION 20-T11N-R10W - FOUND
 43.64' S.E. TO NAIL IN GATE POST
 32.30' E. TO NAIL IN POWER POLE
 40.50' N.E. TO NAIL IN GATE POST
 S.E. CORNER SE1/4 OF SECTION 17-T11N-R10W - FOUND IN ASPH. PAVEMENT
 70.98' N.W. TO NAIL IN FENCE CORNER POST
 72.20' S.W. TO NAIL IN FENCE CORNER POST
 84.50' S.E. TO "X" NAILS IN FENCE CORNER POST

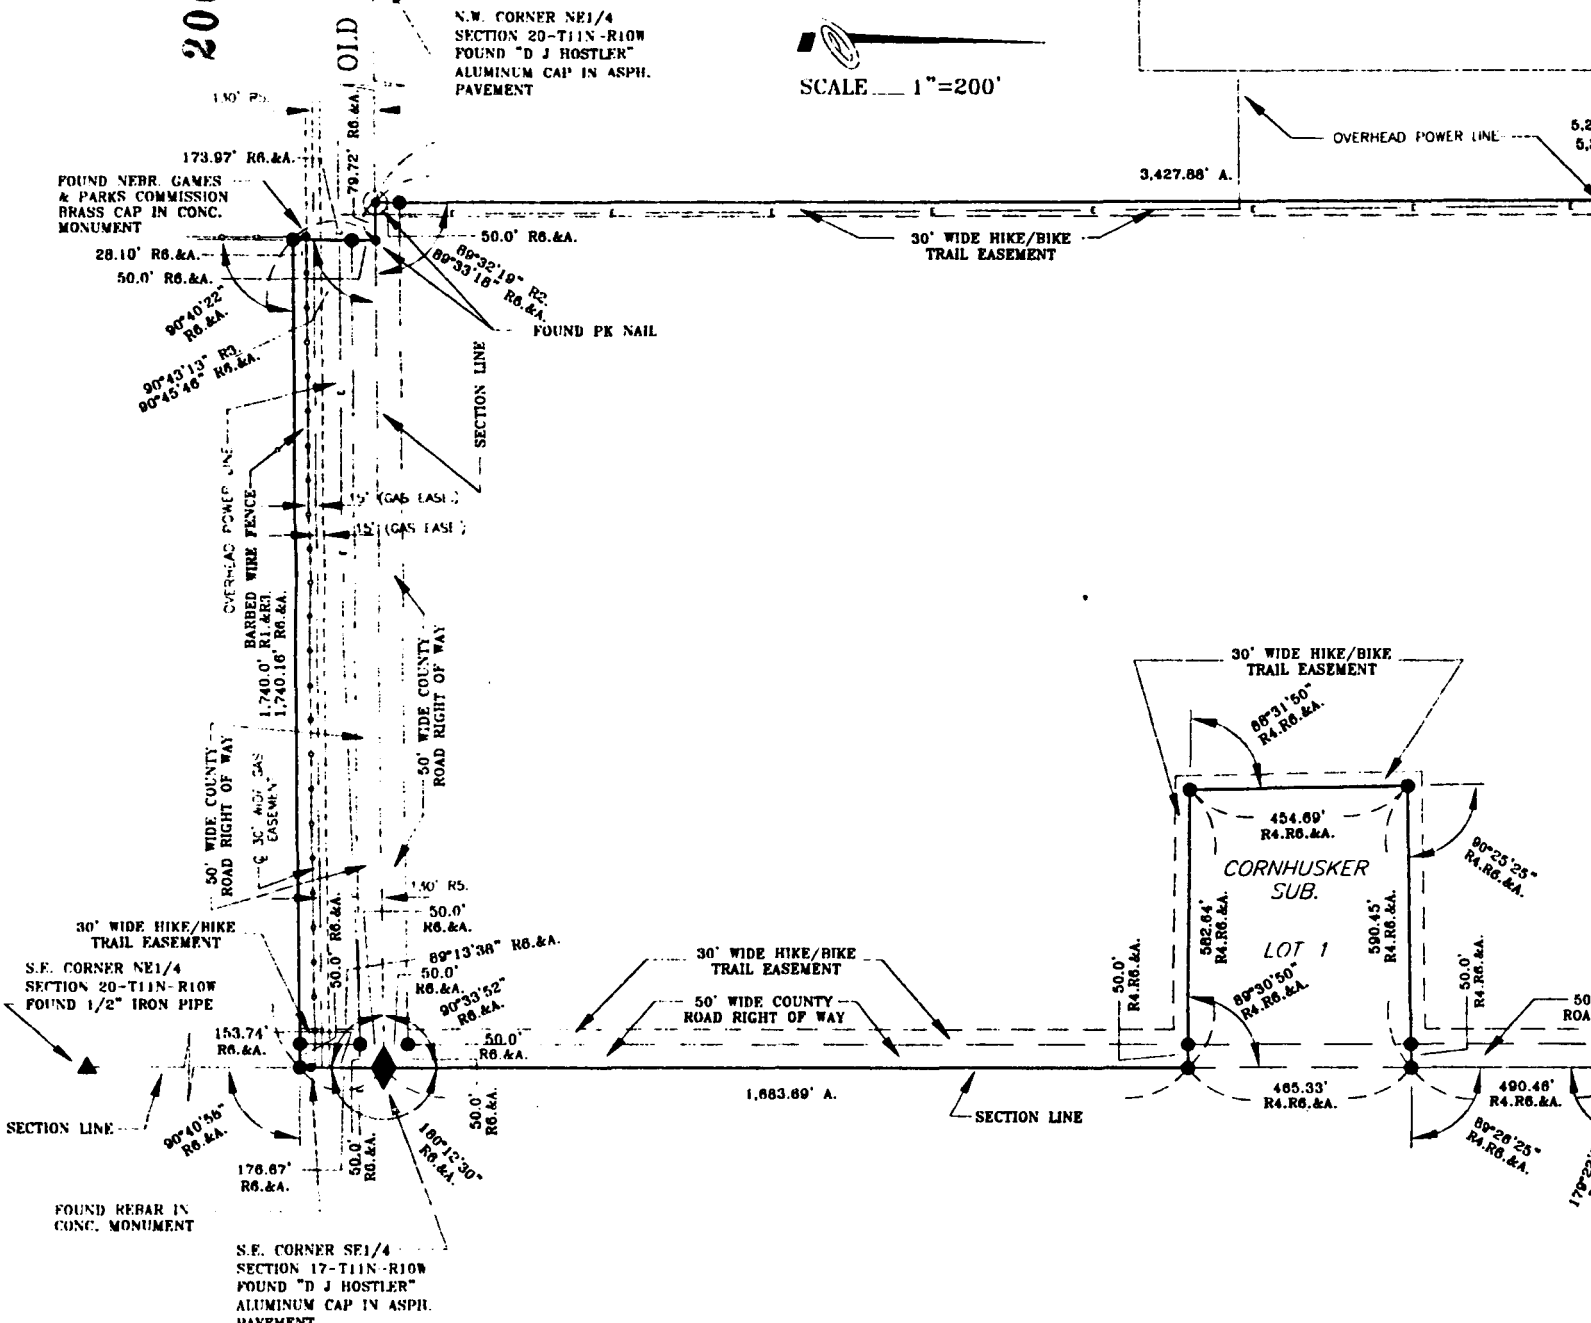

LEGAL DESCRIPTION

A tract of land comprising a part of the Southeast Quarter (SE1/4), and a part of the Northeast Quarter (NE1/4) of Section Seventeen (17), Township Eleven (11) North, Range Ten (10) West of the 6th P.M., and a part of the Northeast Quarter (NE1/4) of Section Twenty (20), Township Eleven (11) North, Range Ten (10) West of the 6th P.M., all being in Hall County, Nebraska, and more particularly described as follows:

Beginning at the southeast corner of the Southeast Quarter (SE1/4) of said Section Seventeen (17); thence running northerly, along and upon the east line of the Southeast Quarter (SE1/4) of said Section Seventeen (17), a distance of One Thousand Six Hundred Eighty Three and Sixty Nine Hundredths (1,683.69) feet to the southeast corner of Cornhusker Subdivision; thence deflecting left 89°30'50" and running westerly, along and upon the south line of said Cornhusker Subdivision, a distance of Five Hundred Eighty Two and Sixty Four Hundredths (582.64) feet to the southwest corner of said Cornhusker Subdivision; thence deflecting right 88°31'50" and running northerly, along and upon the west line of said Cornhusker Subdivision, a distance of Four Hundred Fifty Four and Sixty Nine Hundredths (454.69) feet to the northwest corner of said Cornhusker Subdivision; thence deflecting right 90°25'25" and running easterly, along and upon the north line of said Cornhusker Subdivision, a distance of Five Hundred Ninety and Forty Five Hundredths (590.45) feet to the northeast corner of said Cornhusker Subdivision, said point also being on the east line of the Southeast Quarter (SE1/4) of said Section Seventeen (17); thence deflecting left 89°26'25" and running northerly, along and upon the east line of the Southeast Quarter (SE1/4) of said Section Seventeen (17), a distance of Four Hundred Ninety and Forty Six Hundredths (490.46) feet to the southeast corner of the Northeast Quarter (NE1/4) of said Section Seventeen (17), thence deflecting right 00°37'39" and running northerly, along and upon the east line of the Northeast Quarter (NE1/4) of said Section Seventeen (17), a distance of One Thousand Six Hundred Ninety Seven and Sixty Four Hundredths (1,697.64) feet to a point which is Nine Hundred Fifty (950.0) feet south of the northeast corner of the Northeast Quarter (NE1/4) of said Section Seventeen (17); thence deflecting left 117°18'11" and running southwesterly, a distance of Two Thousand Sixty Five and Five Hundredths (2,065.05) feet; thence deflecting left 83°28'38" and running southerly, a distance of Three Thousand Four Hundred Twenty Seven and Eighty Eight Hundredths (3,427.88) feet to a point on the south line of the Southeast Quarter (SE1/4) of said Section Seventeen (17); thence deflecting left 90°28'42" and running easterly, along and upon the south line of the Southeast Quarter (SE1/4) of said Section Seventeen (17), a distance of Seventy Nine and Seventy Two Hundredths (79.72) feet; thence deflecting right 90°45'46" and running southerly, a distance of One Hundred Seventy Three and Ninety Seven Hundredths (173.97) feet; thence deflecting left 90°40'22" and running easterly, a distance of One Thousand Seven Hundred Forty and Sixteen Hundredths (1,740.16) feet to a point on the east line of the Northeast Quarter (NE1/4) of said Section Twenty (20); thence deflecting left 89°19'02" and running northerly, along and upon the east line of the Northeast Quarter (NE1/4) of said Section Twenty (20), a distance of One Hundred Seventy Six and Sixty Seven Hundredths (176.67) feet; to the point of beginning and containing 163.529 acres, more or less.

FOUND "D J HOSTLER" ALUMINUM CAP


S.E. CORNER NE1/4 OF SECTION 17-T11N-R10W - FOUND 1 3/4" CRIMPED IRON PIPE
51.80' N.W. TO NAIL IN FENCE BRACE POST
51.80' S.W. TO NAIL IN FENCE BRACE POST
32.80' E. TO REBAR IN CONC. W.C.

FOUND 1/2" IRON PIPE

N.E. CORNER NE1/4 OF SECTION 17-T11N-R10W - FOUND ALUMINUM CAP
61.08' N.W. TO NAIL IN FENCE BRACE POST
61.28' S.E. TO NAIL IN POWER POLE
48.49' N.E. TO TOP CENTER OF FIRE HYDRANT

FOUND "D J HOSTLER" ALUMINUM CAP

N.W. CORNER NE1/4 OF SECTION 17-T11N-R10W - FOUND PK NAIL
66.40' S.W. TO NAIL IN 20" TREE
38.40' S.E. TO NAIL IN 12" TREE
63.40' N.E. TO NAIL IN POWER POLE

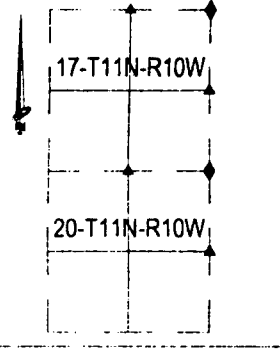

N.W. CORNER NE1/4 SECTION 17-T11N-R10W FOUND PK NAIL

5,288.08' R2.
5,287.88' A.

63°28'38" A.

1,860.0' A.

33.0' R0.&A.

200307151

APPROXIMATE AREA OF RDX CONTAMINATION PLUME (PER DRAWING PROVIDED BY TERRY THONEN, URS GREINER WOODWARD CLYDE, ON JANUARY 4, 2001)

2,065.05' A.

1,859.61' R2.R0.&A.

13TH STREET

50' WIDE COUNTY ROAD RIGHT OF WAY

30' WIDE HIKE/BIKE TRAIL EASEMENT

60TH ROAD

10°22'21" R0.&A.

S.E. CORNER NE1/4 SECTION 17-T11N-R10W FOUND 1 3/4" CRIMPED PIPE

SECTION LINE

1,897.64' A.

2,647.64' R0.&A.

58.27' A.

117°18'11" A.

950.0' A.

62°41'49" A.

N.E. CORNER NE1/4 SECTION 17-T11N-R10W FOUND ALUMINUM CAP

SURVEYOR'S CERTIFICATE

I hereby certify that to the best of my knowledge and belief, the accompanying plat is from an accurate survey of the described property made under my supervision.

Lee D. Wagner
Lee D. Wagner, Registered Land Surveyor No. 557

PART SE1/4 AND NE1/4 OF SECTION 17-T11N-R10W, AND PART NE1/4 OF SECTION 20-T11N-R10W HALL COUNTY, NEBRASKA

LAND SURVEY

BENJAMIN & ASSOCIATES, INC. ENGINEERS & SURVEYORS
P. O. BOX 339 - PHONE 382-8465 - AREA CODE 308 GRAND ISLAND, NEBRASKA 68801-0339

CAMP 388	REVISED 38
12-28-02	
12-31-2002	
L. W.	
12-31-2003	
H/D TRAM	
PLANNING REV.	
C. 7-23-01	
D.H. DWYER	

TRACT NO. 38B

EXHIBIT "A-4" ATTACHED TO AND MADE

A PART OF QUITCLAIM DEED

CERTIFICATE OF AUTHORITY

200307151

I hereby certify that I am the Secretary, of
(Secretary or Attesting Officer)
 the organization named in the foregoing agreement with the United States of
 America; that said organization is organized under the laws of the state of
Nebraska;
(State)
 that the seal, if applicable, affixed to said instrument
 is the seal of said organization; that Gary Hedman,
(Name of Officer)
 who signed said agreement was then General Manager, of said
(Title of Officer)
 organization and has been duly authorized to sign the foregoing agreement on
 behalf of said organization, binding said organization to the terms therein.

I, as the Secretary/Attesting Officer, hereby attest to the validity of the
 Signature of said Officer; and that said signature affixed to such agreement is
 genuine.

IN WITNESS WHEREOF, I have hereunto set my hand and affixed the seal,
 if applicable, of said organization, this 17th day of March, 2003.

Mike Lowry
Secretary or Attesting Officer
 Mike Lowry, Secretary

SOUTHERN PUBLIC POWER DISTRICT,
 a public corporation and political
subdivision of the State of Nebraska
Corporation or Organization

This form certifies that the person signing the attached instrument has the authority to do so. The signature of the Secretary/Attesting Officer and the individual signing the attached instrument cannot be the same.